

Date: Thursday, 5/4/2006 11:14:54 AM  
 User: Kim Johnston

## Process Sheet

<b>Customer</b> : CU-DAR001 Dart Helicopters Services	<b>Drawing Name</b> : INSULATION SOCKS & HOSES
<b>Job Number</b> : 26966	
<b>Estimate Number</b> : 12386	
<b>P.O. Number</b> : N/A	<b>Part Number</b> : D34823
<b>This Issue</b> : 5/4/2006 <b>S.O. No.</b> : N/A	<b>Drawing Number</b> : D3482 REV A
<b>Prsht Rev.</b> : NC	<b>Project Number</b> : N/A
<b>First Issue</b> : N/A <b>Type</b> : PURCHASED PARTS	<b>Drawing Revision</b> : A
<b>Previous Run</b> : N/A	<b>Material</b> : N/A
<b>Written By</b> : SEE COMMENT BELOW	<b>Due Date</b> : 5/28/2006 <b>Qty:</b> 8 <b>Um:</b> Each
<b>Checked &amp; Approved By</b> : [Signature] 06.05.05	
<b>Comment</b> : Est Rev:A New Issue 06-04-21 JLM	

## Additional Product

Job Number:



<b>Seq. #:</b>	<b>Machine Or Operation:</b>	<b>Description :</b>
----------------	------------------------------	----------------------

1.0	D34823P	OUTLET INSULATION SOCK
-----	---------	------------------------



**Comment:** Qty.: 1.0000 Each(s)/Unit Total : 8.0000 Each(s)  
 INLET INSULATION SOCK

2.0	PG	PURCHASING
-----	----	------------



**Comment:** PURCHASING  
 Issue P/O: 1214  
 Fabricate as per Dwg D3482  
 Possible Supplier: Tempco Tec Inc  
 Material release note is required

C206105110 (8)

3.0	PACKAGING 1	PACKAGING RESOURCE #1
-----	-------------	-----------------------



**Comment:** PACKAGING RESOURCE #1  
 Receive & Inspect For Transit Damage  
 Ensure material certification is attached

P610/29 (8)

4.0	QC6	DIMENSIONAL CHECK
-----	-----	-------------------

**Comment:** DIMENSIONAL CHECK

P605-31 (8)

5.0	PACKAGING 1	PACKAGING RESOURCE #1
-----	-------------	-----------------------



**Comment:** PACKAGING RESOURCE #1  
 Identify and Stock  
 Location: 57367

P610/31 (8)

**Dart Aerospace Ltd**

W/O:		WORK ORDER CHANGES					
DATE	STEP	PROCEDURE CHANGE	By	Date	Qty	Approval Chief Eng / Prod Mgr	Approval QC Inspector

Part No: \_\_\_\_\_ PAR #: \_\_\_\_\_ Fault Category: \_\_\_\_\_ NCR: Yes ☐ No ☒ DQA: DP Date: 06/06/01  
 QA: N/C Closed: \_\_\_\_\_ Date: \_\_\_\_\_

NCR:		WORK ORDER NON-CONFORMANCE (NCR)						
DATE	STEP	Description of NC Section A	Corrective Action Section B			Verification Section C	Approval Chief Eng	Approval QC Inspector
			Initial Chief Eng	Action Description Chief Eng	Sign & Date			

**NOTE:** Date & initial all entries

Date: Thursday, 5/4/2006 11:14:54 AM  
User: Kim Johnston

## Process Sheet

Customer: CU-DAR001 Dart Helicopters Services

Drawing Name: INSULATION SOCKS & HOSES

Job Number: 26966

Part Number: D34823

Job Number:



Seq. #:

Machine Or Operation:

Description :

6.0

DC

DOCUMENT CONTROL



Comment: DOCUMENT CONTROL  
Inspection Level 21

SP 06/06/01

Job Completion



U 06-06-01

**Dart Aerospace Ltd**

W/O:		WORK ORDER CHANGES					
DATE	STEP	PROCEDURE CHANGE	By	Date	Qty	Approval Chief Eng / Prod Mgr	Approval QC Inspector

Part No: \_\_\_\_\_ PAR #: \_\_\_\_\_ Fault Category: \_\_\_\_\_ NCR: Yes No DQA: \_\_\_\_\_ Date: \_\_\_\_\_




QA: N/C Closed: \_\_\_\_\_ Date: \_\_\_\_\_

NCR:		WORK ORDER NON-CONFORMANCE (NCR)						
DATE	STEP	Description of NC Section A	Corrective Action Section B			Verification Section C	Approval Chief Eng	Approval QC Inspector
			Initial Chief Eng	Action Description Chief Eng	Sign & Date			

**NOTE:** Date & initial all entries

**DART**

DESIGN #	DRAWN BY #	DART AEROSPACE LTD HAWKESBURY, ONTARIO, CANADA	
CHECKED #	APPROVED #	DRAWING NO. D3482	REV. A SHEET 1 OF 3
DATE 06.03.24		TITLE INSULATION SOCKS & HOSES	SCALE 1:4
A	06.03.24	NEW ISSUE	

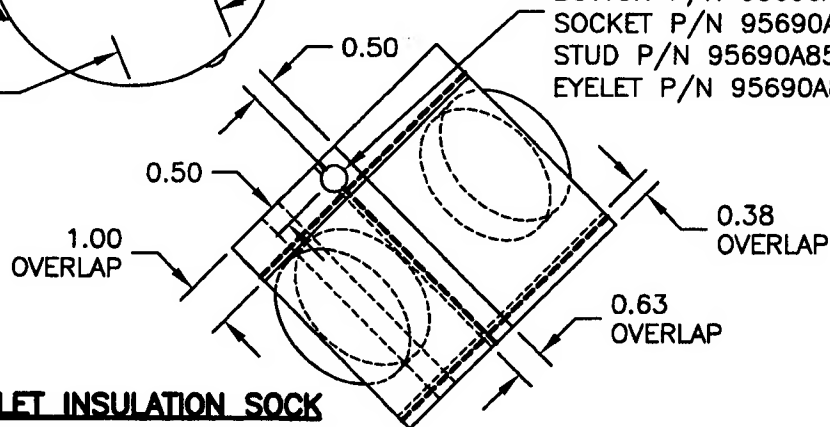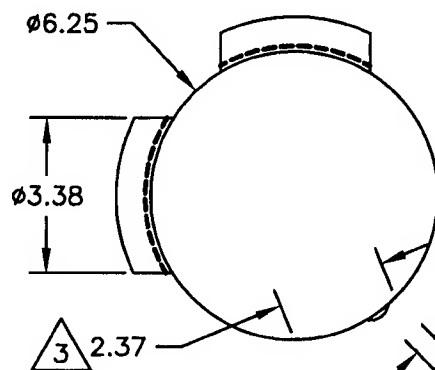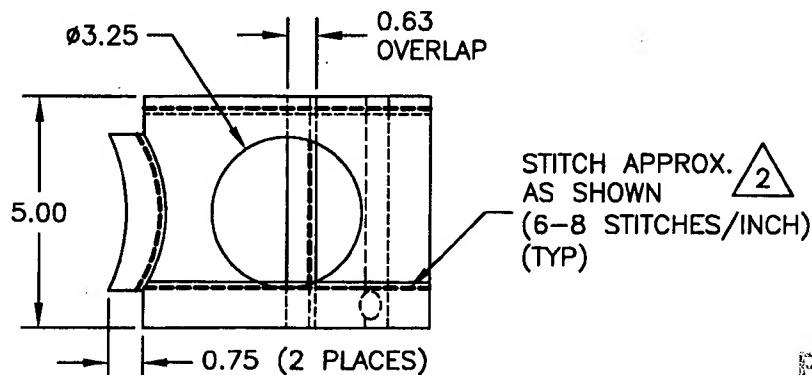

HEAVY DUTY 9/16" SS SNAP FASTENER:  
BUTTON P/N 95690A851  
SOCKET P/N 95690A852  
STUD P/N 95690A853  
EYELET P/N 95690A854

**D3482-1 INLET INSULATION SOCK****NOTES:**

- 1) MATERIAL: BEIGE TECGLASS GL 2025/9383 PER MIL-C-20079H  
TYPE I, CLASS 9 (WITH 9383 FINISH)  
POSSIBLE SUPPLIER: TEMPRO TEC INC.
- 2) THREAD: E-18 FIBERGLASS-TFE THREAD PER MIL-C-20079H(SH)  
TYPE III, CLASS 3 OR ASTM D 4040-89  
POSSIBLE SUPPLIER: TEMPRO TEC INC.
- 3) OPEN/CLOSE OVERLAP WITH SNAP BUTTON
- 4) POSSIBLE SUPPLIER: McMASTER-CARR
- 5) ALL DIMENSIONS ARE IN INCHES
- 6) TOLERANCES ARE PER DART QSI 018 UNLESS OTHERWISE NOTED
- 7) BREAK SHARP EDGES 0.005 TO 0.010 MAX

SHOP COPY  
RETURN TO  
ENGINEERING  
UNCONTROLLED COPY  
SUBJECT TO AMENDMENT  
WITHOUT NOTICE  
WORK ORDER


NO. 26966

Copyright © 2006 by DART AEROSPACE LTD

THIS DOCUMENT IS PRIVATE AND CONFIDENTIAL AND IS SUPPLIED ON THE EXPRESS CONDITION THAT IT IS NOT TO BE USED FOR ANY PURPOSE OR COPIED OR COMMUNICATED TO ANY OTHER PERSON WITHOUT WRITTEN PERMISSION FROM DART AEROSPACE LTD.

**DART**

DESIGN <i>[Signature]</i>	DRAWN BY <i>[Signature]</i>	DART AEROSPACE LTD HAWKESBURY, ONTARIO, CANADA	
CHECKED <i>[Signature]</i>	APPROVED <i>[Signature]</i>	DRAWING NO. D3482	REV. A SHEET 2 OF 3
DATE 06.03.24		TITLE INSULATION SOCKS & HOSES	SCALE 1:4

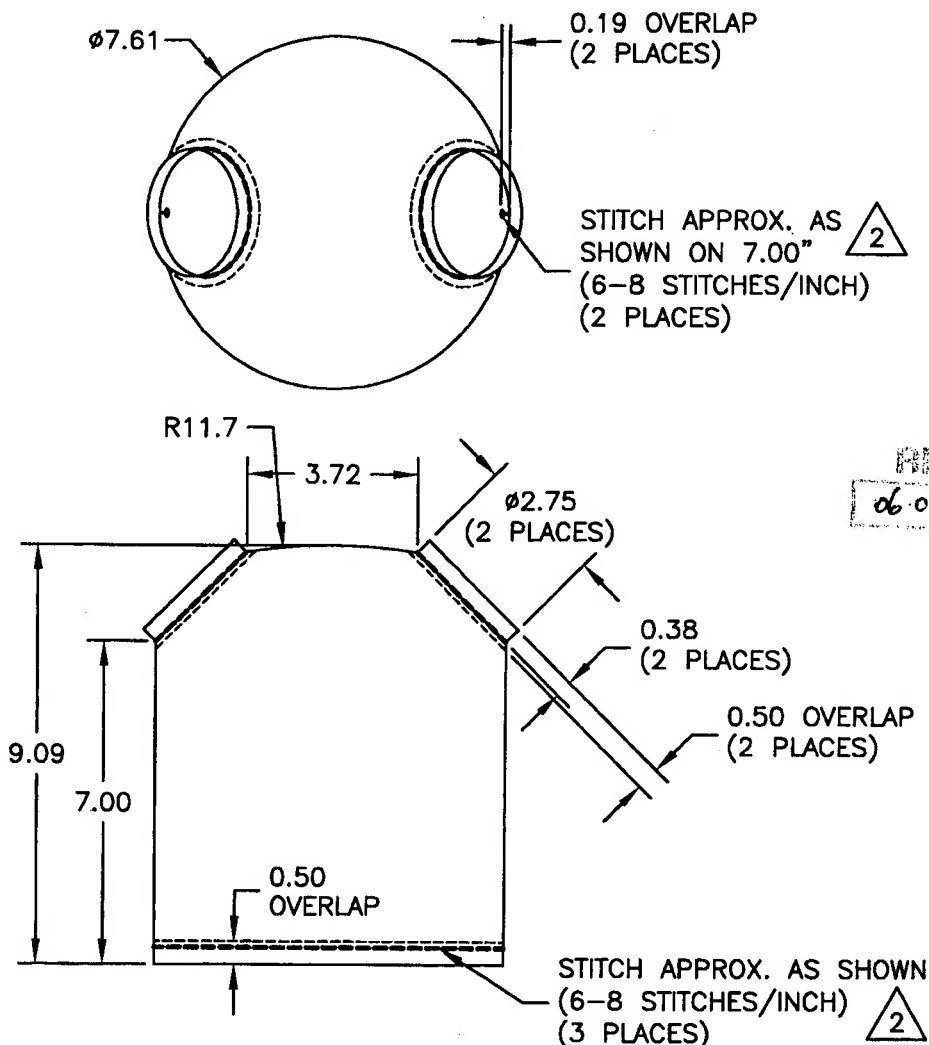**D3482-3 OUTLET INSULATION SOCK****NOTES:**

- 1) MATERIAL: BEIGE TECGLASS GL 2025/9383 PER MIL-C-20079H  
TYPE I, CLASS 9 (WITH 9383 FINISH)  
POSSIBLE SUPPLIER: TEMPRO TEC INC.
- 2) THREAD: E-12 FIBERGLASS-TFE THREAD PER MIL-C-20079H(SH)  
TYPE III, CLASS 3 OR ASTM D 4040-89  
POSSIBLE SUPPLIER: TEMPRO TEC INC.
- 3) ALL DIMENSIONS ARE IN INCHES
- 4) TOLERANCES ARE PER DART QSI 018 UNLESS OTHERWISE NOTED
- 5) BREAK SHARP EDGES 0.005 TO 0.010 MAX


SHOP COPY  
RETURN TO  
ENGINEERING  
UNCONTROLLED COPY  
SUBJECT TO AMENDMENT  
WITHOUT NOTICE  
WORK ORDER  
NO. 26966

**Copyright © 2006 by DART AEROSPACE LTD**

THIS DOCUMENT IS PRIVATE AND CONFIDENTIAL AND IS SUPPLIED ON THE EXPRESS CONDITION THAT IT IS NOT TO BE USED FOR ANY PURPOSE OR COPIED OR COMMUNICATED TO ANY OTHER PERSON WITHOUT WRITTEN PERMISSION FROM DART AEROSPACE LTD.



DESIGN <i>[Signature]</i>	DRAWN BY <i>[Signature]</i>	<b>DART AEROSPACE LTD</b> HAWKESBURY, ONTARIO, CANADA	
CHECKED <i>[Signature]</i>	APPROVED <i>[Signature]</i>	DRAWING NO. D3482	REV. A SHEET 3 OF 3
DATE 06.03.24		TITLE INSULATION SOCKS & HOSES	SCALE 1:4

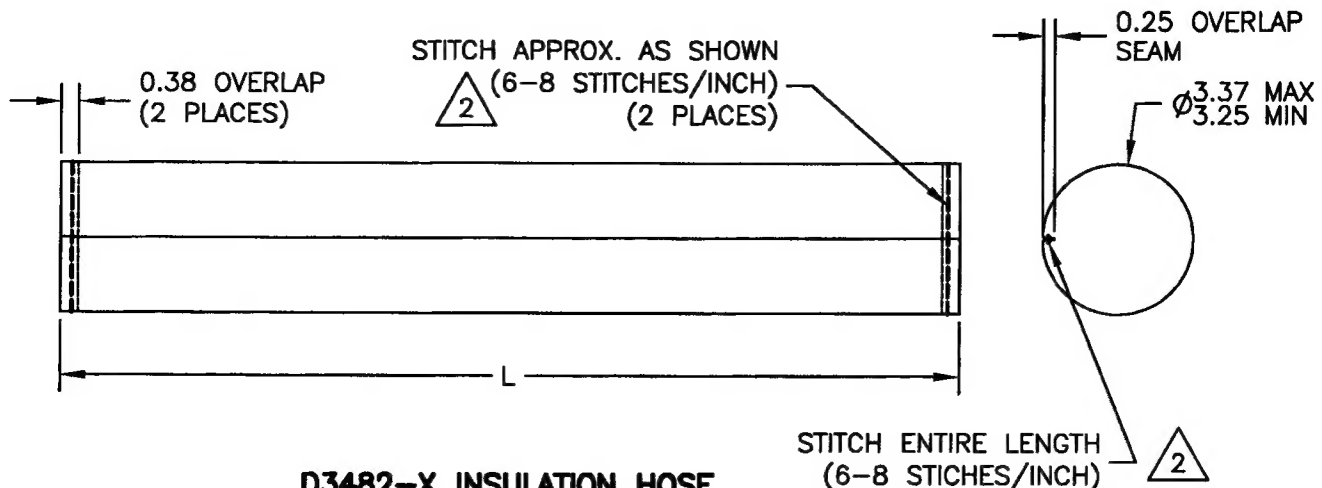

**D3482-X INSULATION HOSE**

P/N D3482-X	L (in)
D3482-5	20
D3482-7	36
D3482-9	48
D3482-11	30
D3482-13	40

RELEASED  
06-04-03 *[Signature]*

**NOTES:**

- 1) MATERIAL: BEIGE TECGLASS GL 2025/9383 PER MIL-C-20079H  
TYPE I, CLASS 9 (WITH 9383 FINISH)  
POSSIBLE SUPPLIER: TEMPRO TEC INC.
- 2) THREAD: E-12 FIBERGLASS-TFE THREAD PER MIL-C-20079H(SH)  
TYPE III, CLASS 3 OR ASTM D 4040-89  
POSSIBLE SUPPLIER: TEMPRO TEC INC.
- 3) ALL DIMENSIONS ARE IN INCHES
- 4) TOLERANCES ARE PER DART QSI 018 UNLESS OTHERWISE NOTED
- 5) BREAK SHARP EDGES 0.005 TO 0.010 MAX

SHOP COPY  
RETURN TO  
ENGINEERING

UNCONTROLLED COPY  
SUBJECT TO AMENDMENT  
WITHOUT NOTICE

WORK ORDER

NO. *26966*

Copyright © 2006 by DART AEROSPACE LTD

THIS DOCUMENT IS PRIVATE AND CONFIDENTIAL AND IS SUPPLIED ON THE EXPRESS CONDITION THAT IT IS NOT TO BE USED FOR ANY PURPOSE OR COPIED OR COMMUNICATED TO ANY OTHER PERSON WITHOUT WRITTEN PERMISSION FROM DART AEROSPACE LTD.



7210 C - 5<sup>th</sup> Street SE  
Calgary, Alberta  
T2H 2L9

## Technical Data Sheet

Bus: 403-216-3300  
Fax: 403-216-3306  
www.temprotec.com

### TECGLASS™ GL 2025/9383



APPROVED

FM STANDARD 4950 \*  
WELDING CURTAINS

TEMPERATURE RESISTANCE	1000° F	
CONTENT	100% FIBERGLASS YARNS	
WEAVE	PLAIN	
WEIGHT	18.0 oz / yd <sup>2</sup>	
THICKNESS	0.036"	
COLOR	BEIGE	
COUNT	WARP: 19	FILL: 14
FABRIC FINISH	PLAIN OR 9383 (HEAT CLEANED) **	
USCG SPECIFICATIONS	164.009 "TEST FOR INCOMBUSTIBILITY"	
MILITARY SPECIFICATIONS	MIL C 20079H TYPE 1 CLASS 9 (WITH 9383 FINISH)	
SIZE	40" & 60" x 50 lyds	
FEATURES	TECGLASS™ IS SAFE, TOUGH AND VERSATILE	

35.36 e2.

2

P-0 1214

\*\* HEAT CLEANED (9383) MATERIAL HAS BEEN APPROVED AS A WELDING CURTAIN UNDER FM APPROVAL STANDARD 4950 FOR HOT WORK PROTECTION

\* NOTE: WELDING PADS AND WELDING BLANKETS MAY ALSO BE USED AS WELDING CURTAINS.

THE INFORMATION PRESENTED IS INTENDED AS A SPECIFICATION GUIDE ONLY. MATERIALS SHOULD BE TESTED FOR ITS SUITABILITY IN ANY APPLICATION. USERS SHOULD ALSO FAMILIARIZE THEMSELVES WITH THE MSDS BEFORE HANDLING. NO WARRANTIES ARE EXPRESSED OR IMPLIED AS APPLICATION CONDITIONS ARE BEYOND OUR CONTROL





7210 C - 5<sup>th</sup> Street SE  
Calgary, Alberta  
T2H 2L9

## Technical Data Sheet

Bus: 403-216-3300  
Fax: 403-216-3306  
www.temprotec.com

### FIBERGLASS-TFE THREAD

	<u>E-12</u>	<u>E-18</u>	<u>E-24</u>
FILAMENT SIZE	0.014"	0.017"	0.020"
YIELD	2975 yds / lb	2000 yds / lb	1475 yds / lb
AVERAGE BREAK STRENGTH	14 lbs	19 lbs	27 lbs
SPECIFICATIONS			MIL-C 20079H(SH) TYPE III, CLASS 3 ASTM D 4030-89

PACKAGING APPROX.	2.0 lbs / SPOOL	2.0 lbs / SPOOL	2.0 lbs / SPOOL
-------------------	-----------------	-----------------	-----------------

#### FEATURES

- CONTINUOUS FILAMENT FIBERGLASS THREAD COATED WITH PTFE (TEFLON)
- WILL NOT BURN, -400° F TO 1000° F (-204°C TO 538°C)
- UNAFFECTED BY FUNGI AND MOST ACIDS/ALKALIS
- FLEXIBLE, HIGH ABRASION RESISTANCE
- IMPROVED SEWABILITY

THE INFORMATION PRESENTED IS INTENDED AS A SPECIFICATION GUIDE ONLY. MATERIALS SHOULD BE TESTED FOR ITS SUITABILITY IN ANY APPLICATION. USERS SHOULD ALSO FAMILIARIZE THEMSELVES WITH THE MSDS BEFORE HANDLING. NO WARRANTIES ARE EXPRESSED OR IMPLIED AS APPLICATION CONDITIONS ARE BEYOND OUR CONTROL.